COMPT	DOORS	OPENING DIMENSIONS	INSIDE DIMENSIONS	VOLUME
L1	HINGED	16.25"W x 35.25"H	23.25"W x 38.25"H x 26.50"D	13.64 CU. FT.
L2	HINGED	32.75"W x 25.25"H	41.25"W x 23.50"H x 26.50"D	14.86 CU. FT.
L3	HINGED	49.25"W x 25.25"H	57.75"W x 23.50"H x 26.50"D	20.81 CU. FT.
L4	HINGED	31.75"W x 49.50"H	37.75"W x 52.50"H x 26.50"D	30.39 CU. FT.
L5	HINGED	38.50"W x 49.50"H	45.50"W x 52.50"H X 26.50"D	36.63 CU. FT.
L6	HINGED	15.50"W x 39.25"H	22.50"W x 42.25"H X 26.50"D	14.58 CU. FT.

COMPT	DOORS	OPENING DIMENSIONS	INSIDE DIMENSIONS	VOLUME
R1	HINGED	36.75"W x 34.43"H	40.75"W x 38.43"H x 23.00"D	20.84 CU. FT.
R2	HINGED	31.75"W x 26.00"H	37.75"W x 29.00"H x 26.50"D	16.79 CU. FT.
R3	HINGED	38.50"W x 26.00"H	45.50"W x 29.00"H X 26.50"D	20.24 CU. FT.
R4	HINGED	15.50"W x 16.00"H	22.50"W x 19.00"H X 26.50"D	6.55 CU. FT.
A1	HINGED	25.00"W x 9.50"H	25.00"W x 9.50"H X 88.00" D	12.09 CU. FT.
			TOTAL VOLUME	208 CU. FT.

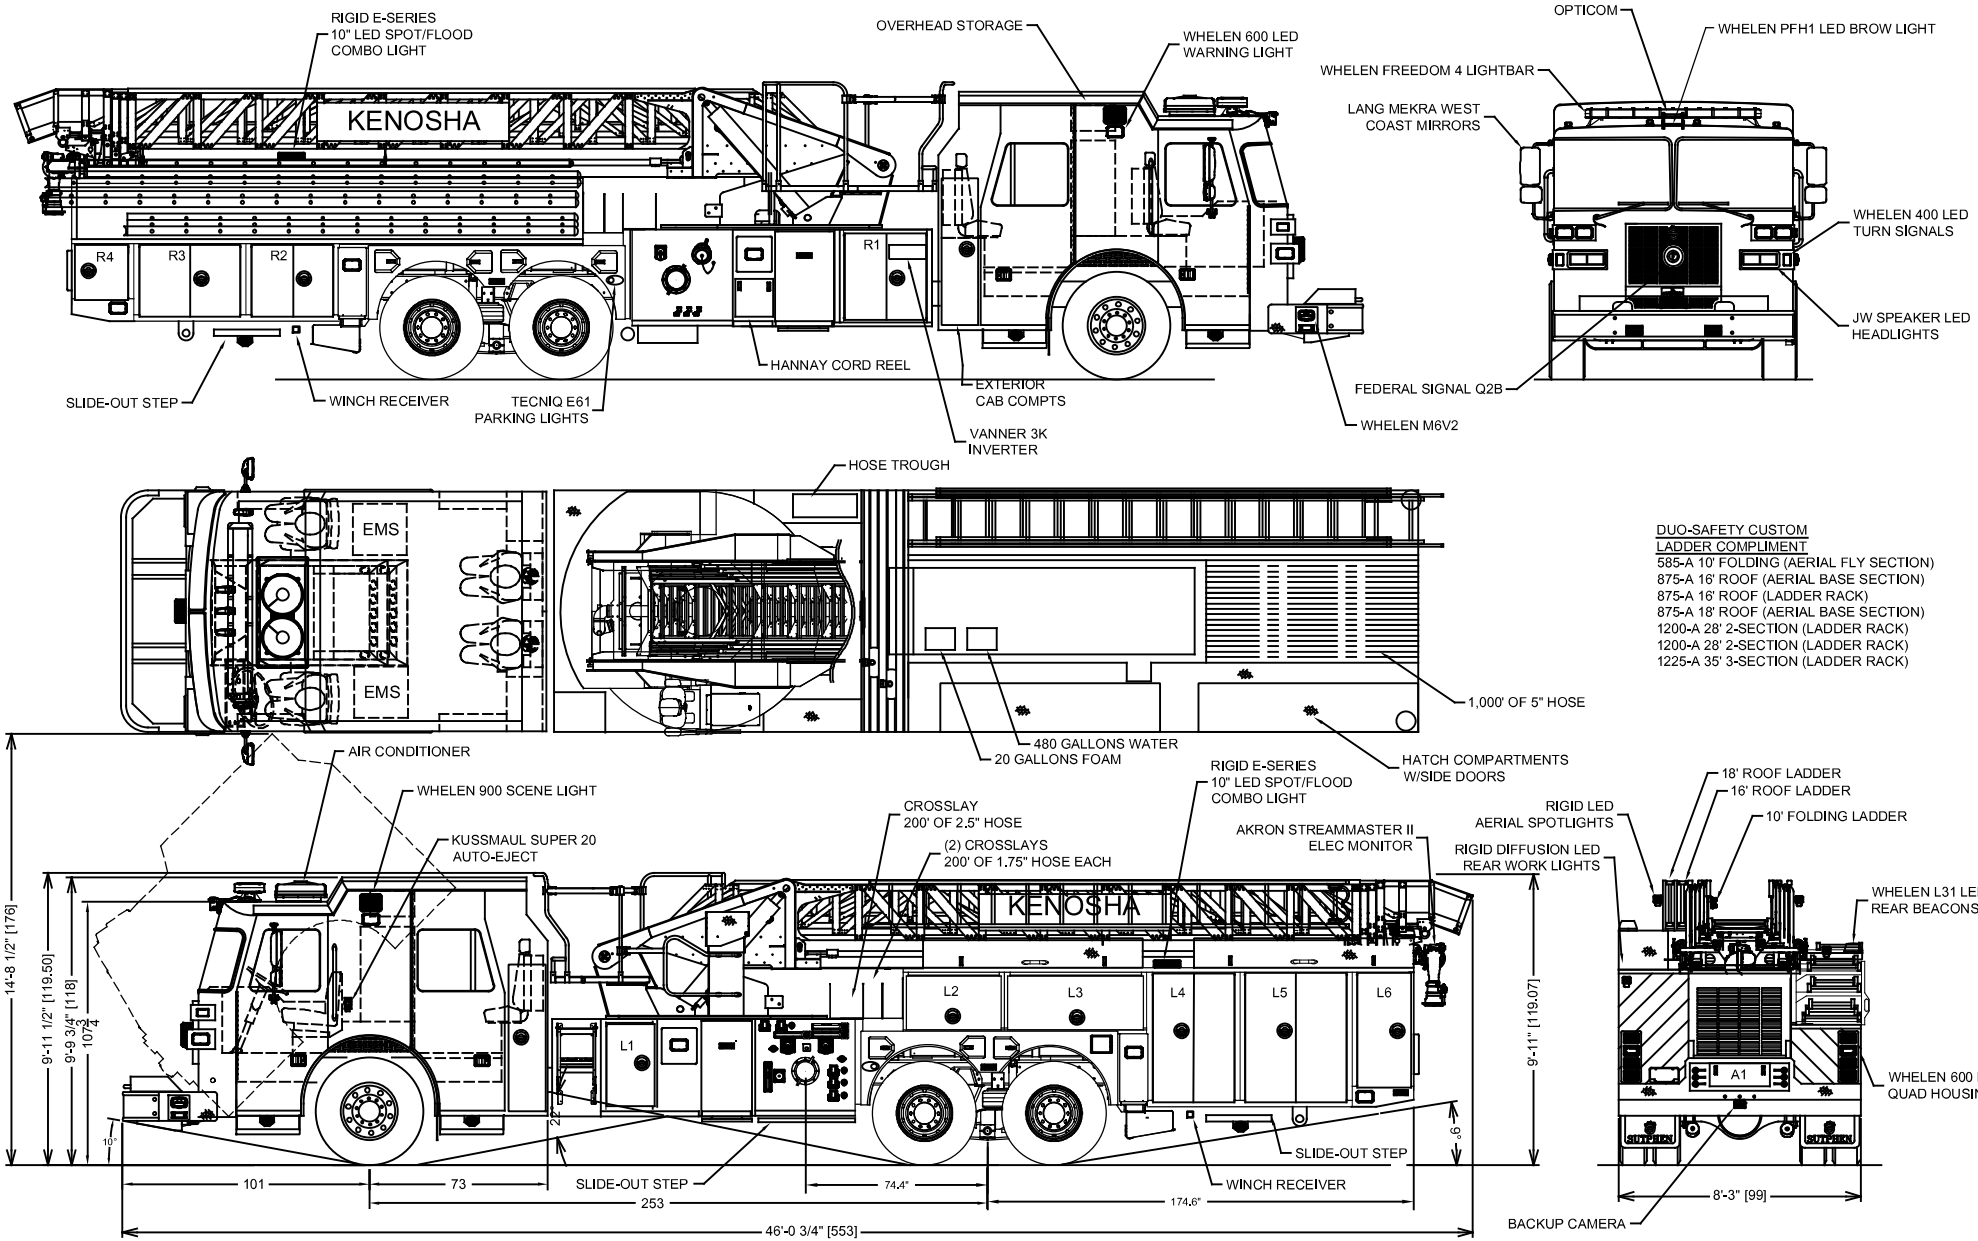

DUO-SAFETY CUSTOM LADDER COMPLIMENT
585-A 10' FOLDING (AERIAL FLY SECTION)
875-A 16' ROOF (AERIAL BASE SECTION)
875-A 16' ROOF (LADDER RACK)
875-A 18' ROOF (AERIAL BASE SECTION)
1200-A 28' 2-SECTION (LADDER RACK)
1200-A 28' 2-SECTION (LADDER RACK)
1225-A 35' 3-SECTION (LADDER RACK)

DIMENSIONS SHOWN ON THIS DRAWING ARE APPROXIMATE AND ARE SUBJECT TO MINOR DEVIATIONS DURING CONSTRUCTION.

IN THE EVENT OF A DISCREPANCY BETWEEN THE SUTPHEN SPECIFICATIONS AND DRAWING, THE SUTPHEN SPECIFICATIONS SHALL PREVAIL.

DRAWING IS FOR REFERENCE ONLY. SOME ITEMS PROPOSED MAY NOT BE SHOWN OR NOTED.

CUSTOMER APPROVAL

NAME:

TITLE:

DATE:

REV.	DESCRIPTION	BY	DATE
G.0	UPDATED TO MATCH AS BUILT TRUCK	CAM	2/18/2021

THIS PRINT IS PROVIDED ON A RESTRICTED BASIS AND IS NOT TO BE USED IN ANY WAY DETRIMENTAL TO THE INTEREST OF SUTPHEN CORPORATION.

DRAWN BY: APF

DATE: 03/11/2019

MFG. FACILITY: HILLIARD

SUTPHEN

KENOSHA FIRE DEPARTMENT
KENOSHA, WI

SL100

DWG. NO.: HS-XXXX